


NOTES

THE CONTRACTOR TO CHECK ALL WORKING DIMENSIONS ON SITE BEFORE PUTTING ANY WORK IN HAND. ANY DISCREPANCY SHALL BE BROUGHT TO THE ATTENTION OF THE PROJECT OFFICER WITHOUT DELAY

- ③ Door held open/wedge
- ↔ Two way flow in Corridors.
- ② NUMBER IN SQUARE NOTES MAXIMUM OCCUPANCY FOR EACH AREA.

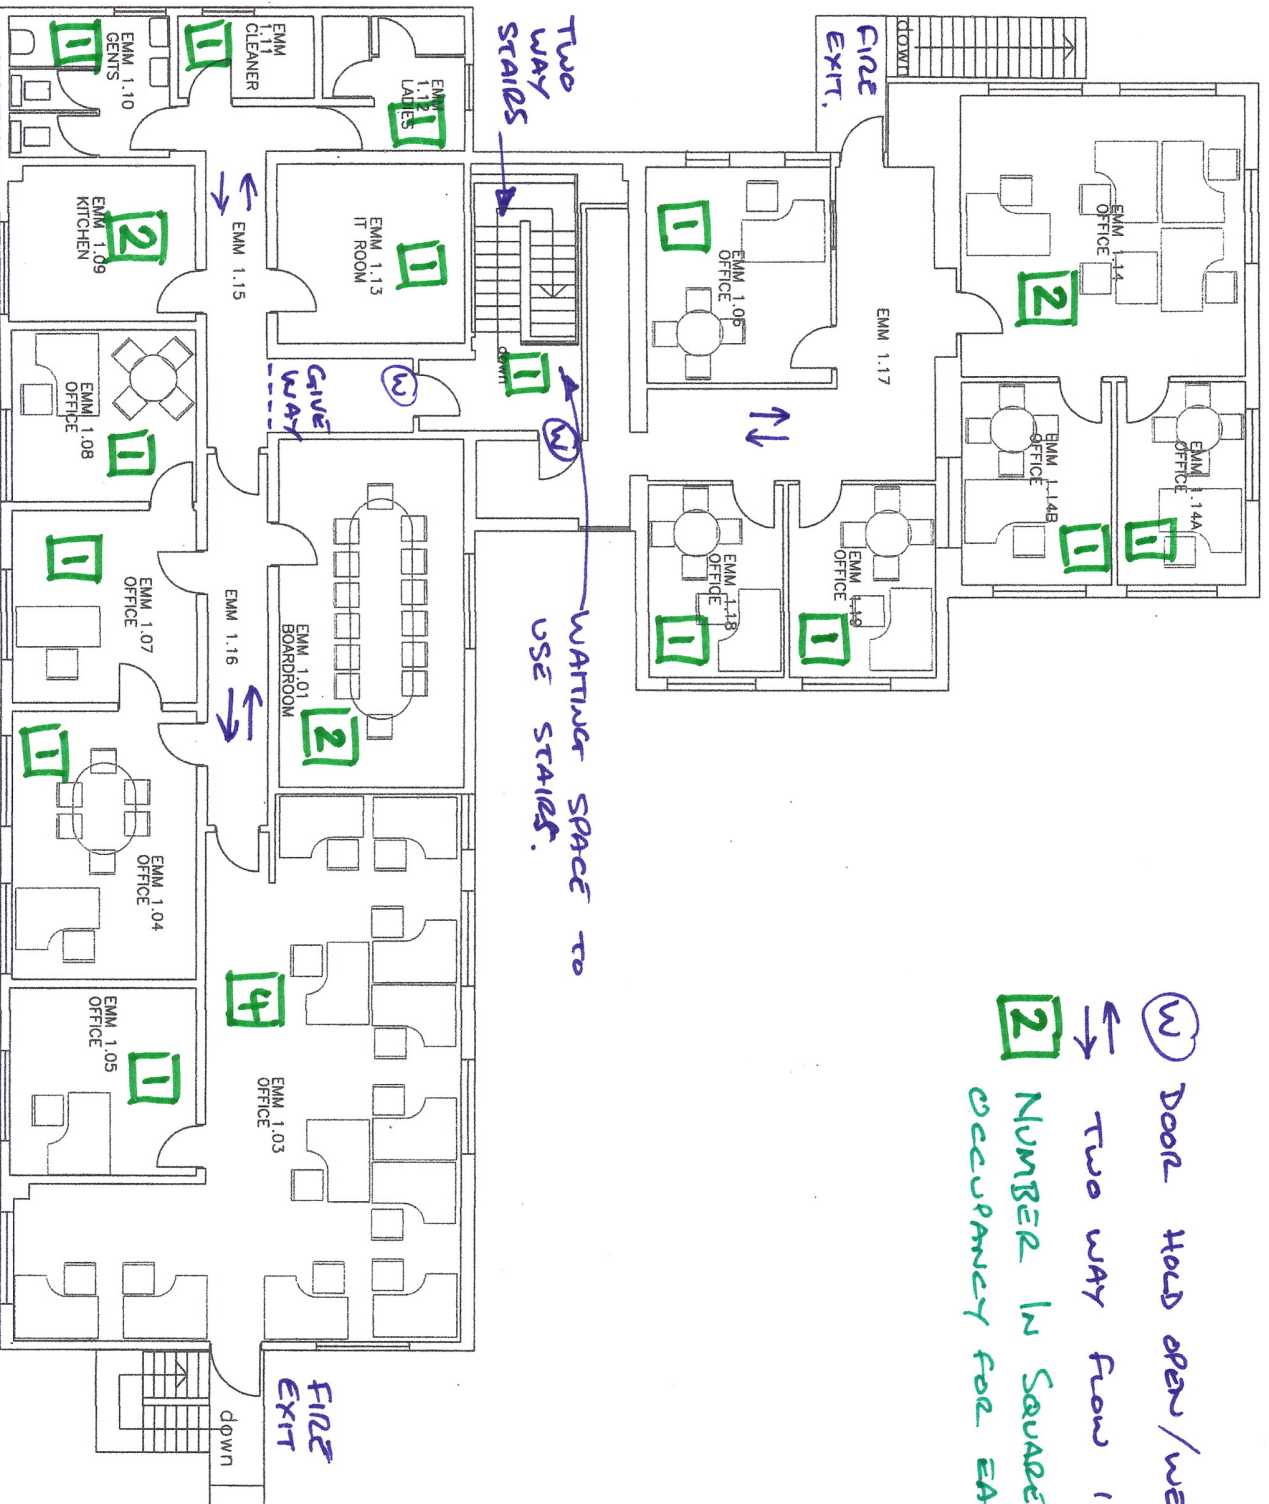

AS CONSTRUCTED

REV	DATE	AMENDMENTS
G	25/09/2015	Fire escape added.
H	12/04/2016	Meeting room added.
I	29/06/2017	Meeting Room & Projects Office alterations
J	09/05/2019	Update rooms name.

PROJECT OFFICER

PROJECT
B003 - WILLIAM EMES

DESCRIPTION OF SHEET
FIRST FLOOR PLAN

SHEET NUMBER OF

DRAWN BY
A DEAN

DATE
JUNE 2013

SCALE
1:100 @ A3

FILE NUMBER

DRAWING NUMBER
B003-X-02-1

REVISION J DRAWING SIZE A3



ESTATES & DEVELOPMENT DIRECTORATE,
KEELE
STAFFORDSHIRE
ST5 5BG