


CHANCELLORS A BLOCK

GROUND FLOOR

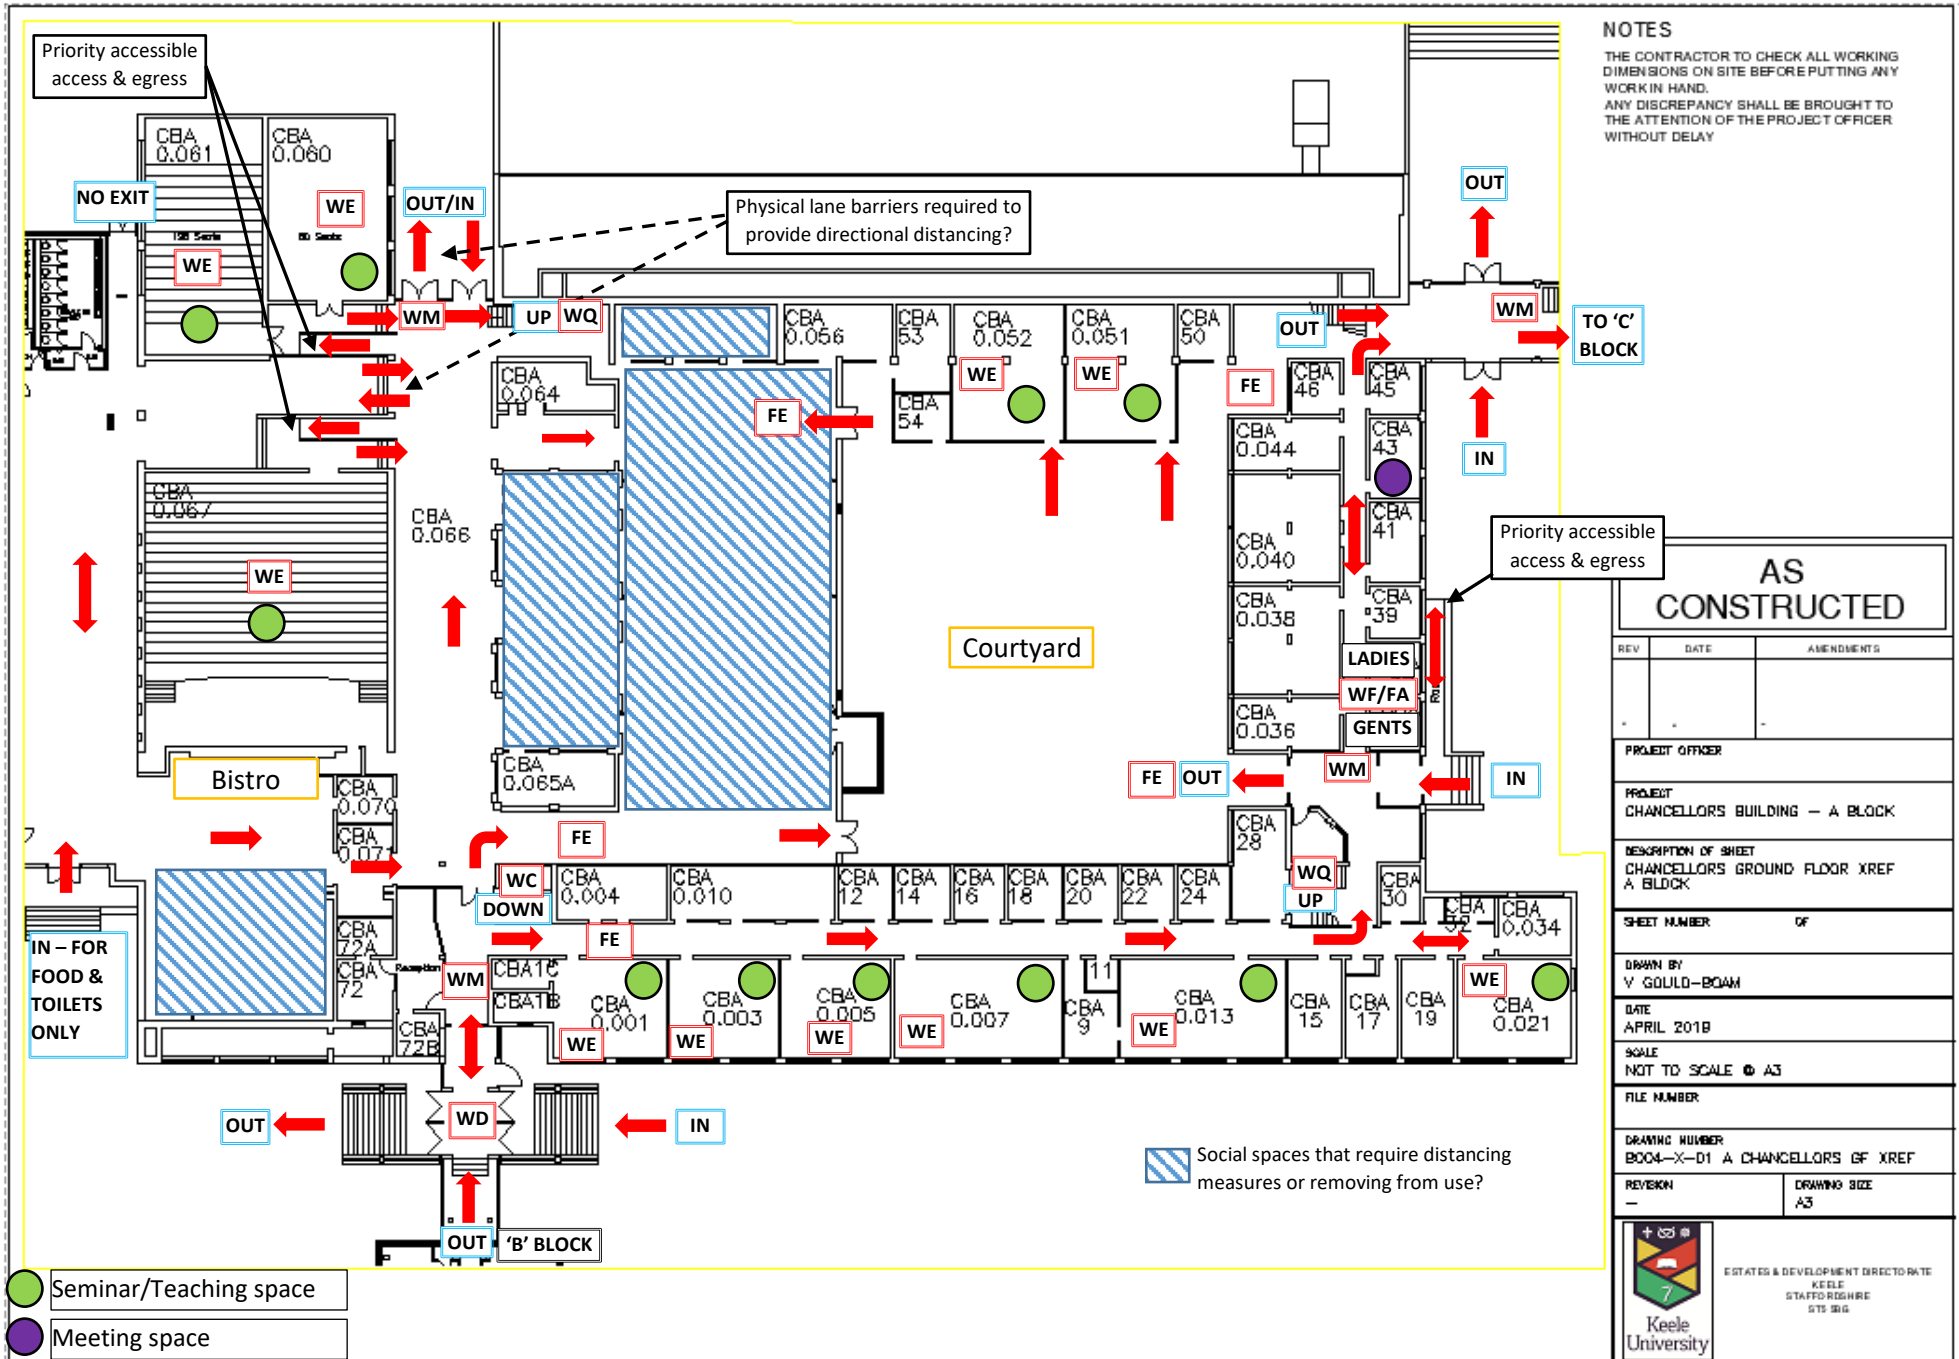

NOTES
 THE CONTRACTOR TO CHECK ALL WORKING DIMENSIONS ON SITE BEFORE PUTTING ANY WORK IN HAND.
 ANY DISCREPANCY SHALL BE BROUGHT TO THE ATTENTION OF THE PROJECT OFFICER WITHOUT DELAY

AS CONSTRUCTED

REV	DATE	AMENDMENTS
PROJECT OFFICER		
PROJECT CHANCELLORS BUILDING - A BLOCK		
DESCRIPTION OF SHEET CHANCELLORS GROUND FLOOR XREF A BLOCK		
SHEET NUMBER OF		
DRAWN BY V GOULD-BOAM		
DATE APRIL 2018		
SCALE NOT TO SCALE @ A3		
FILE NUMBER		
DRAWING NUMBER BO04-X-D1 A CHANCELLORS OF XREF		
REVISION		DRAWING SIZE A3




ESTATES & DEVELOPMENT DIRECTORATE
 KEELE
 STAFFORDSHIRE
 ST5 5BG

- Seminar/Teaching space
- Meeting space

Social spaces that require distancing measures or removing from use?

CHANCELLORS A BLOCK

FIRST FLOOR

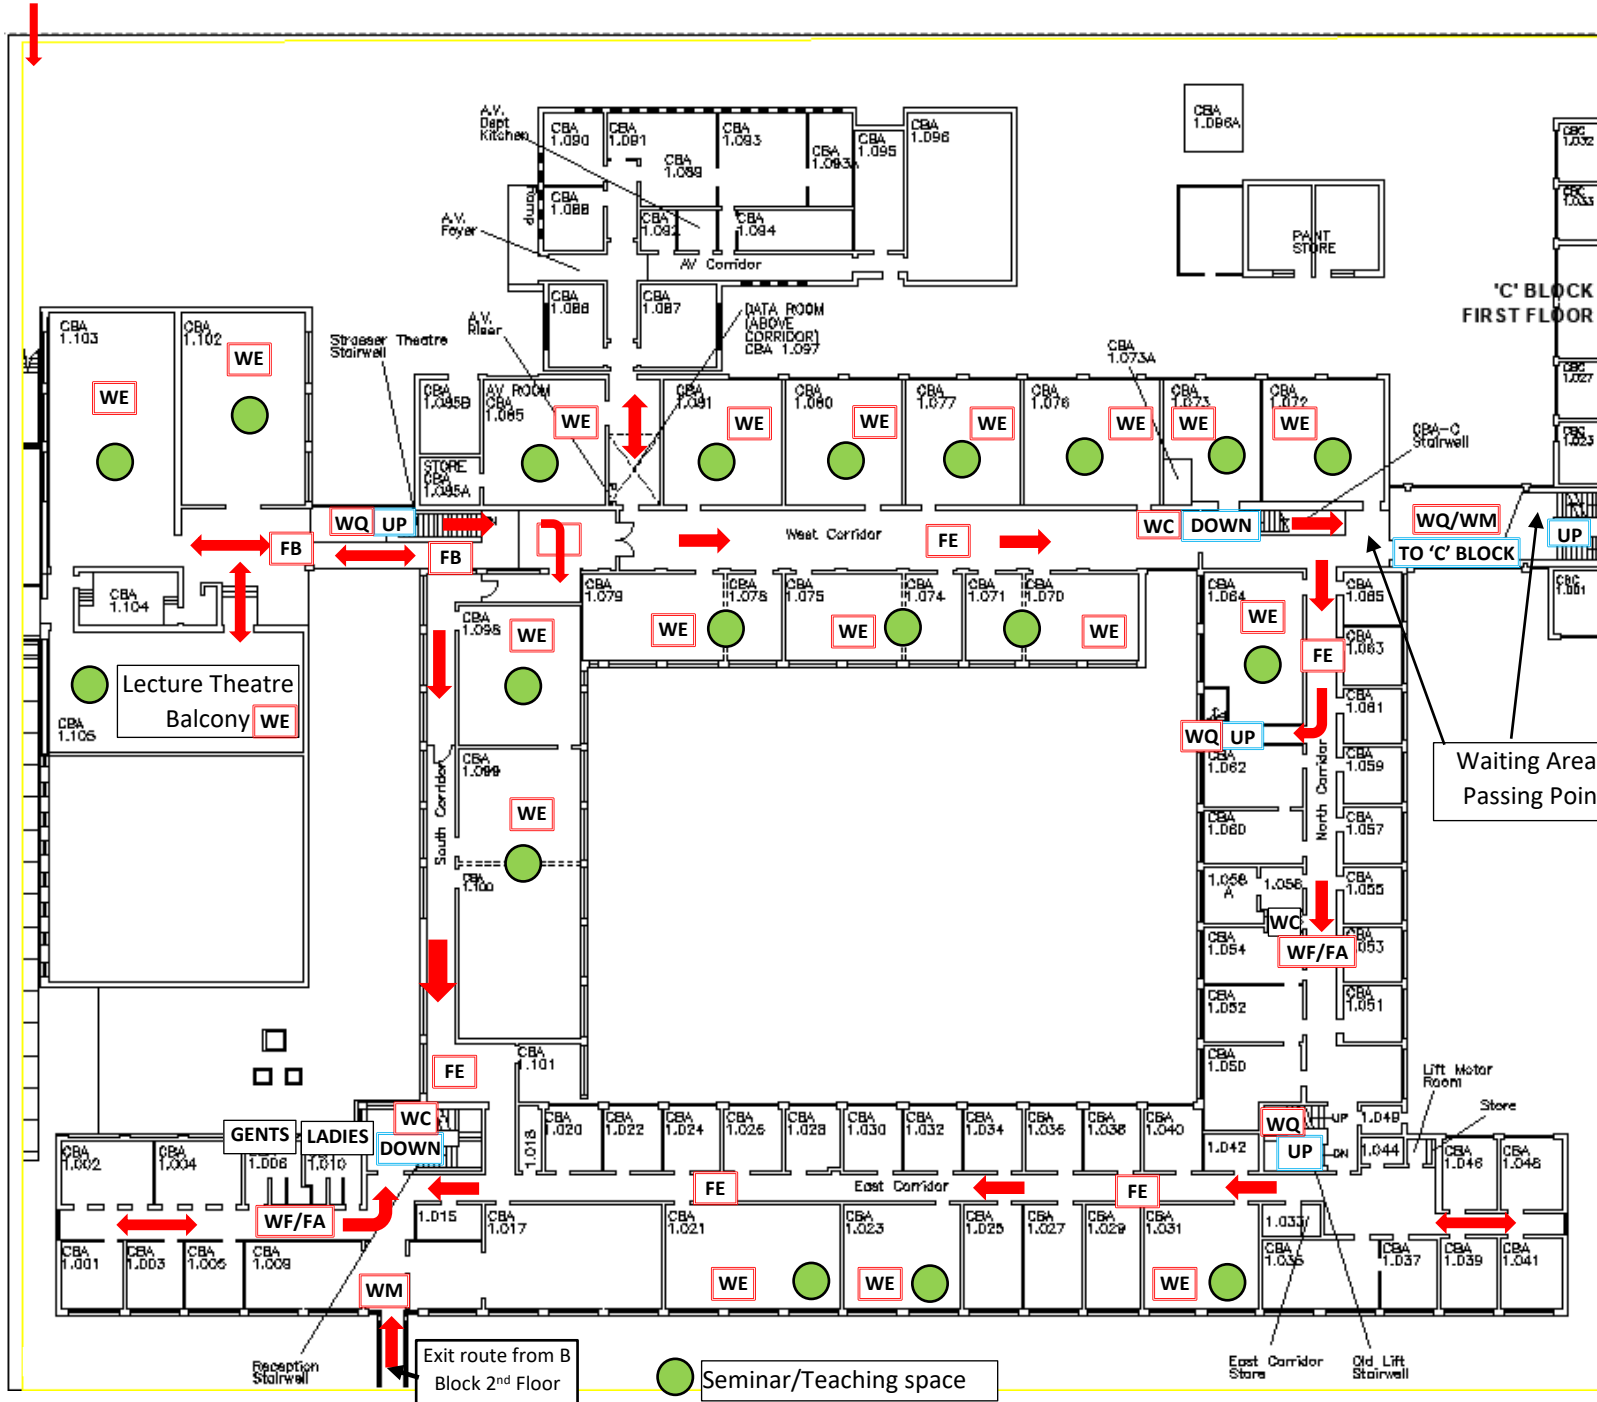


NOTES
 THE CONTRACTOR TO CHECK ALL WORKING DIMENSIONS ON SITE BEFORE PUTTING ANY WORK IN HAND.
 ANY DISCREPANCY SHALL BE BROUGHT TO THE ATTENTION OF THE PROJECT OFFICER WITHOUT DELAY

'C' BLOCK FIRST FLOOR
 CHANCELLORS BUILDING FIRST FLOOR A BLOCK

AS CONSTRUCTED

REV	DATE	AMENDMENTS
PROJECT OFFICER		
PROJECT CHANCELLORS BUILDING - A BLOCK		
DESCRIPTION OF SHEET CHANCELLORS FIRST FLOOR XREF A BLOCK		
SHEET NUMBER		OF
DRAWN BY V GOULD-BOAM		
DATE APRIL 2019		
SCALE NOT TO SCALE @ A3		
FILE NUMBER		
DRAWING NUMBER 8004-X-02 A CHANCELLORS FF XREF		
REVISION	DRAWING SIZE	
-	A3	



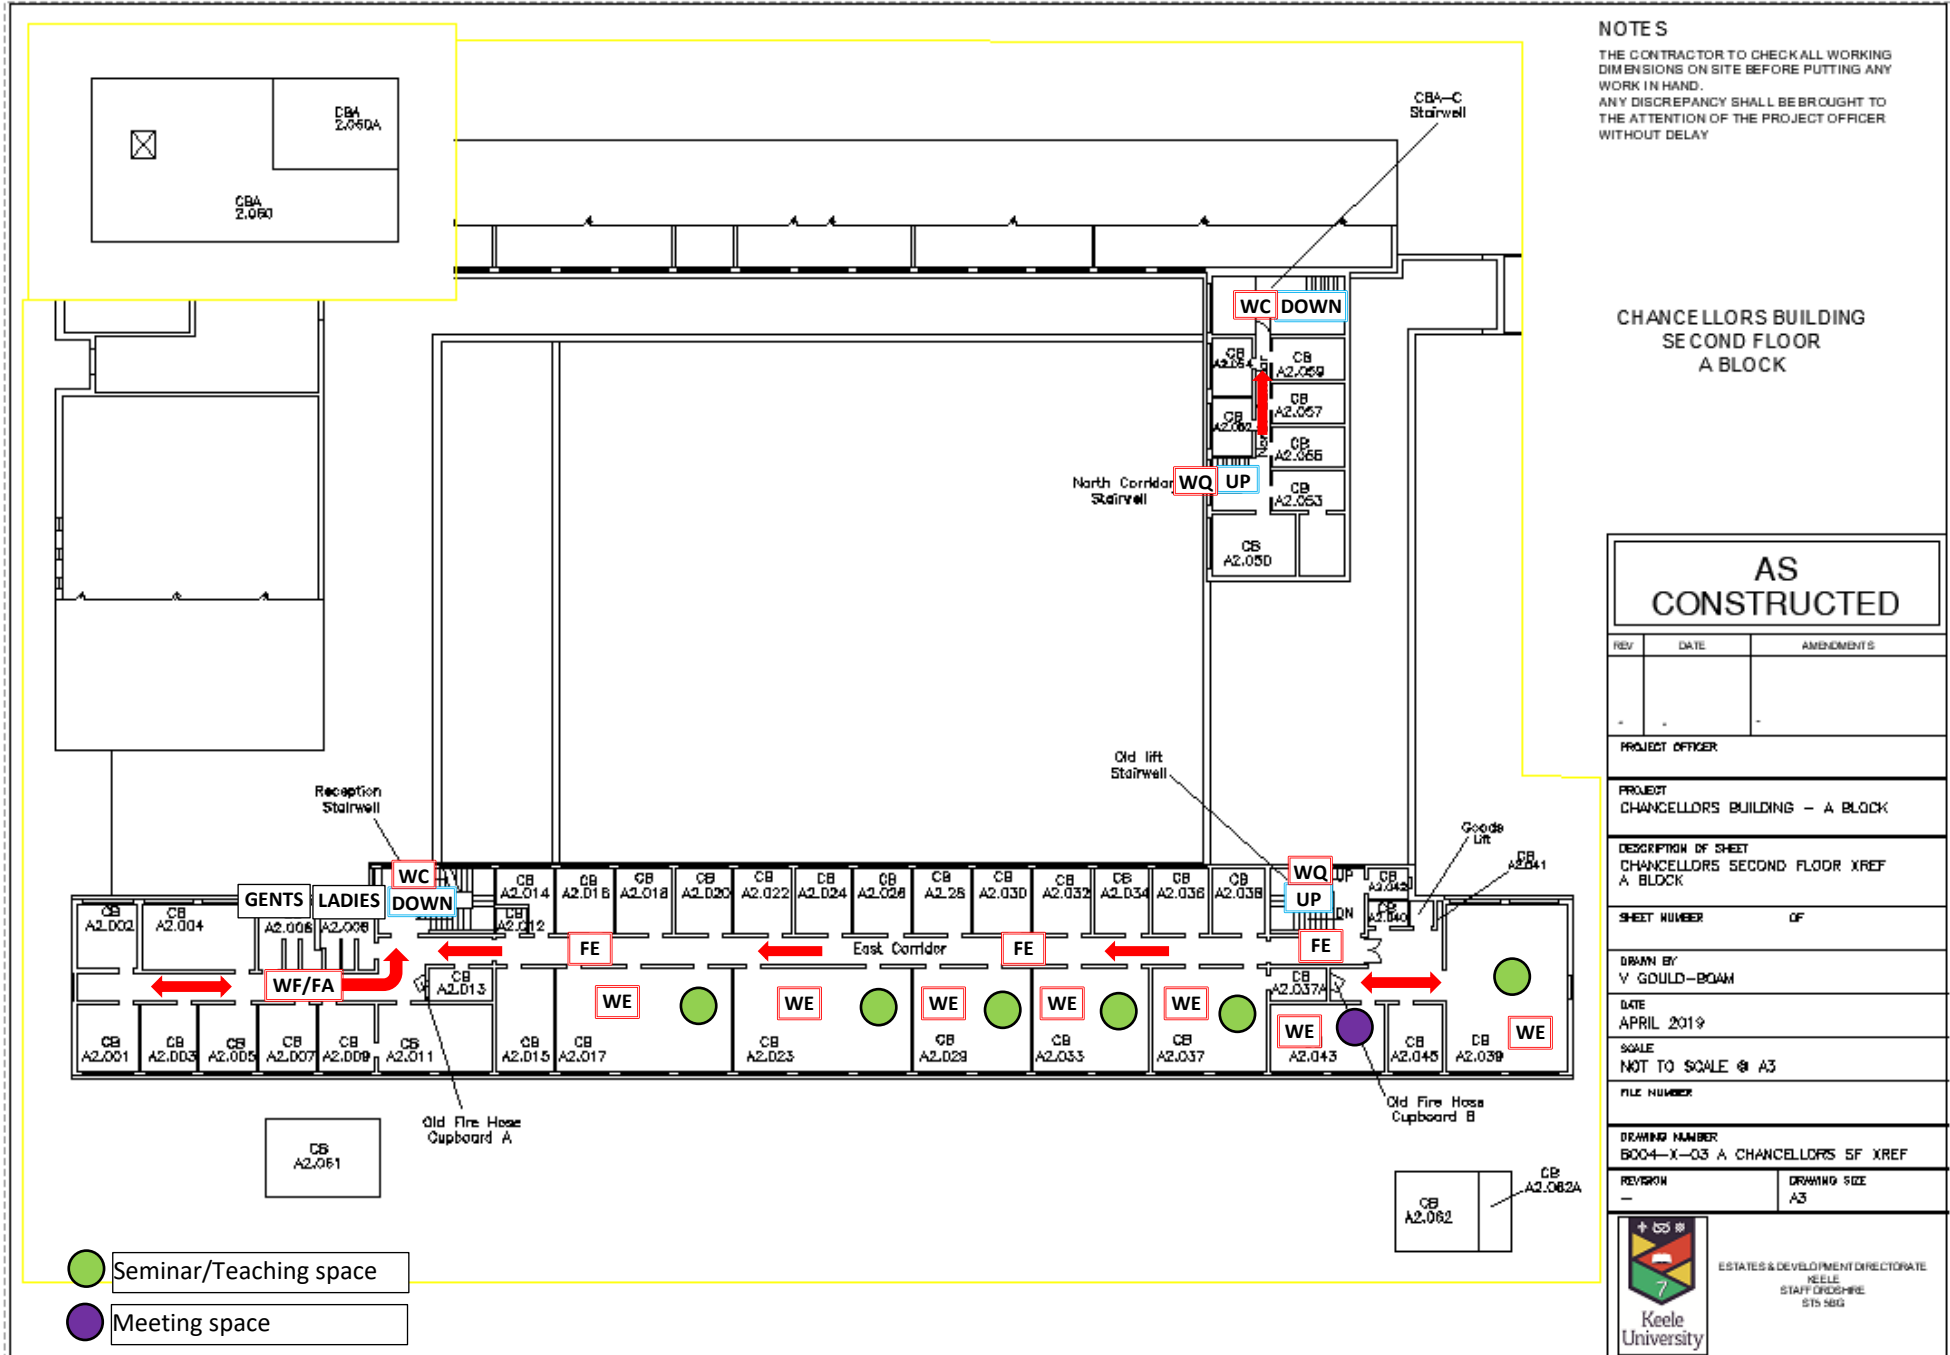

NOTES
 THE CONTRACTOR TO CHECK ALL WORKING DIMENSIONS ON SITE BEFORE PUTTING ANY WORK IN HAND.
 ANY DISCREPANCY SHALL BE BROUGHT TO THE ATTENTION OF THE PROJECT OFFICER WITHOUT DELAY

CHANCELLORS BUILDING
 SECOND FLOOR
 A BLOCK

**AS
 CONSTRUCTED**

REV	DATE	AMENDMENTS

PROJECT OFFICER

PROJECT
 CHANCELLORS BUILDING - A BLOCK

DESCRIPTION OF SHEET
 CHANCELLORS SECOND FLOOR XREF
 A BLOCK

SHEET NUMBER OF

DRAWN BY
 V GOULD-BGAM

DATE
 APRIL 2019

SCALE
 NOT TO SCALE @ A3

FILE NUMBER

DRAWING NUMBER
 B004-X-03 A CHANCELLORS SF XREF

REVISION DRAWING SIZE
 A3



ESTATES & DEVELOPMENT DIRECTORATE
 YELLE
 STAFF CROSSHIRE
 STS MBG