


NOTES

THE CONTRACTOR TO CHECK ALL WORKING DIMENSIONS ON SITE BEFORE PUTTING ANY WORK IN HAND.
ANY DISCREPANCY SHALL BE BROUGHT TO THE ATTENTION OF THE PROJECT OFFICER WITHOUT DELAY

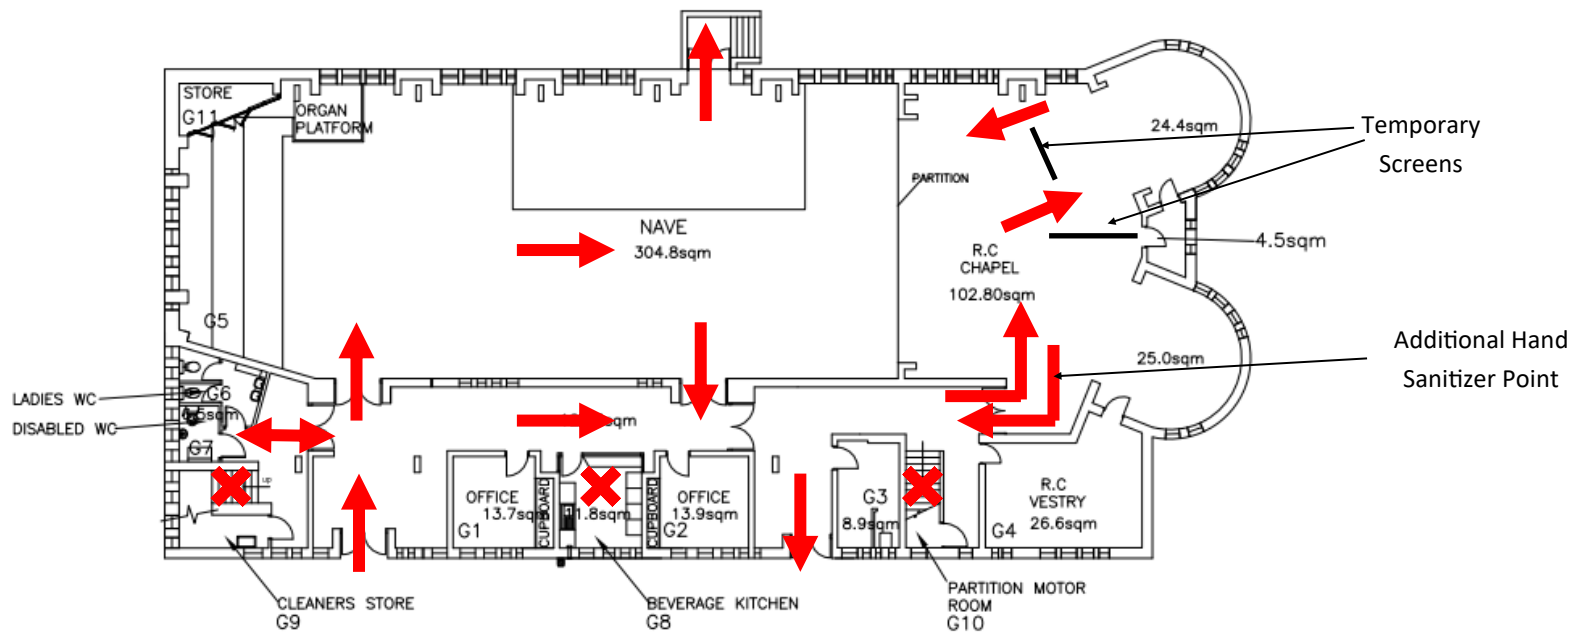

**AS
CONSTRUCTED**

REV	DATE	AMENDMENTS
B	27/10/2014	Room numbers G6 to G11 added and organ platform added.

PROJECT OFFICER

PROJECT CHAPEL

DESCRIPTION OF SHEET
GROUND FLOOR PLAN (AREA 702 SQ M)

SHEET NUMBER OF

DRAWN BY
A DEAN

DATE
JULY 2013

SCALE
1:200 @ A3

FILE NUMBER

DRAWING NUMBER
B014-X-01-1

REVISION B	DRAWING SIZE A3
---------------	--------------------




ESTATES & DEVELOPMENT DIRECTORATE
KEELE
STAFFORDSHIRE
ST5 5BG

Keele University

NOTES

THE CONTRACTOR TO CHECK ALL WORKING DIMENSIONS ON SITE BEFORE PUTTING ANY WORK IN HAND. ANY DISCREPANCY SHALL BE BROUGHT TO THE ATTENTION OF THE PROJECT OFFICER WITHOUT DELAY

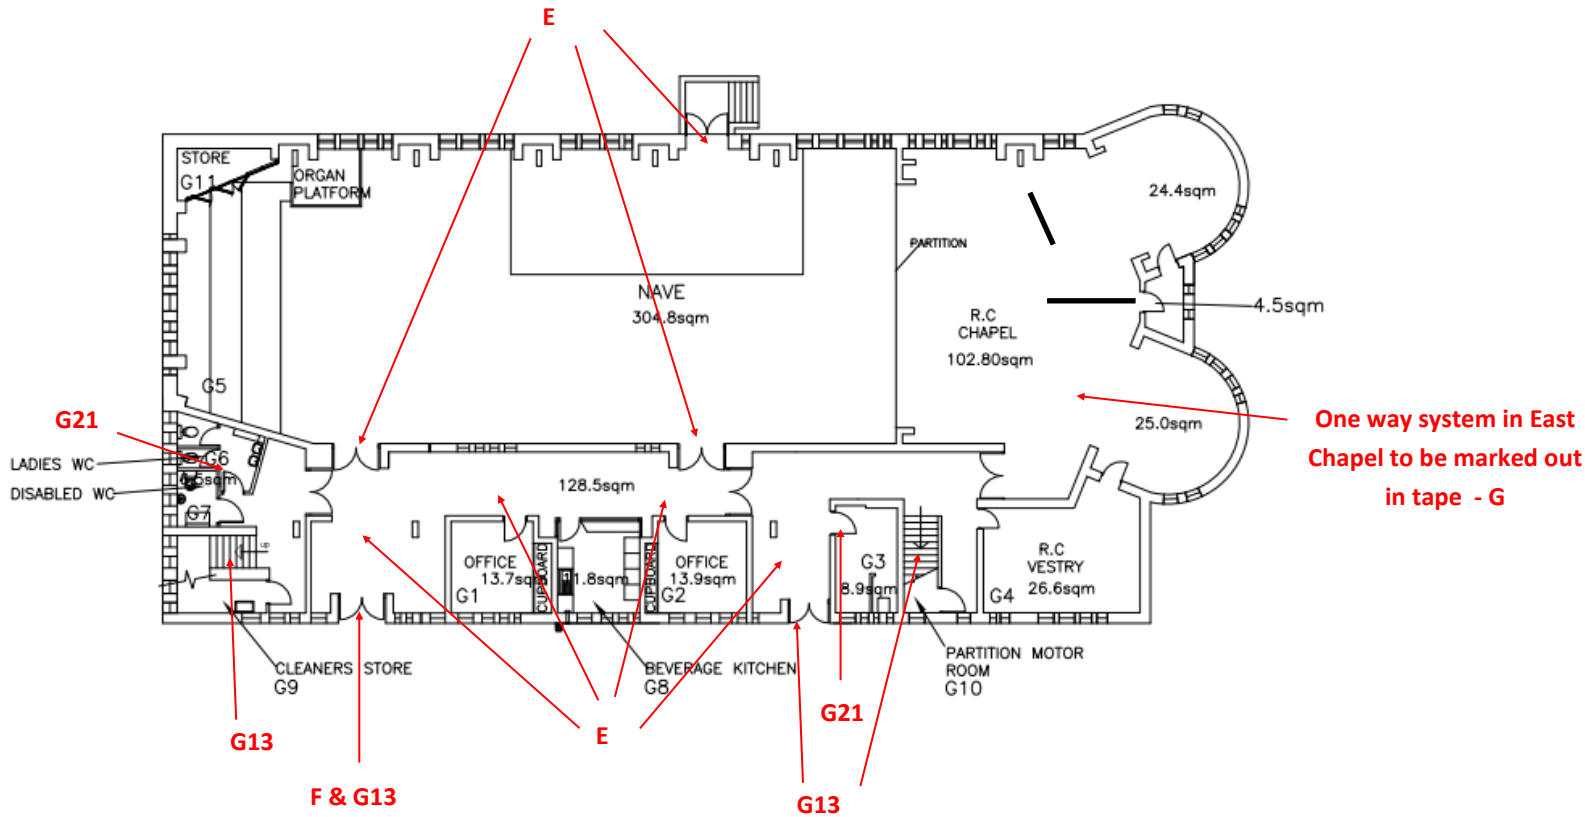

AS CONSTRUCTED

REV	DATE	AMENDMENTS
B	27/10/2014	Room numbers G6 to G11 added and organ platform added.

PROJECT OFFICER

PROJECT CHAPEL

DESCRIPTION OF SHEET
GROUND FLOOR PLAN (AREA 702 SQ M)

SHEET NUMBER OF

DRAWN BY
A DEAN

DATE
JULY 2013

SCALE
1:200 @ A3

FILE NUMBER

DRAWING NUMBER
B014-X-01-1

REVISION B	DRAWING SIZE A3
---------------	--------------------



ESTATES & DEVELOPMENT DIRECTORATE
KEELE
STAFFORDSHIRE
ST5 5BG

Keele University