


**NOTES**

THE CONTRACTOR TO CHECK ALL WORKING DIMENSIONS ON SITE BEFORE PUTTING ANY WORK IN HAND. ANY DISCREPANCY SHALL BE BROUGHT TO THE ATTENTION OF THE PROJECT OFFICER WITHOUT DELAY

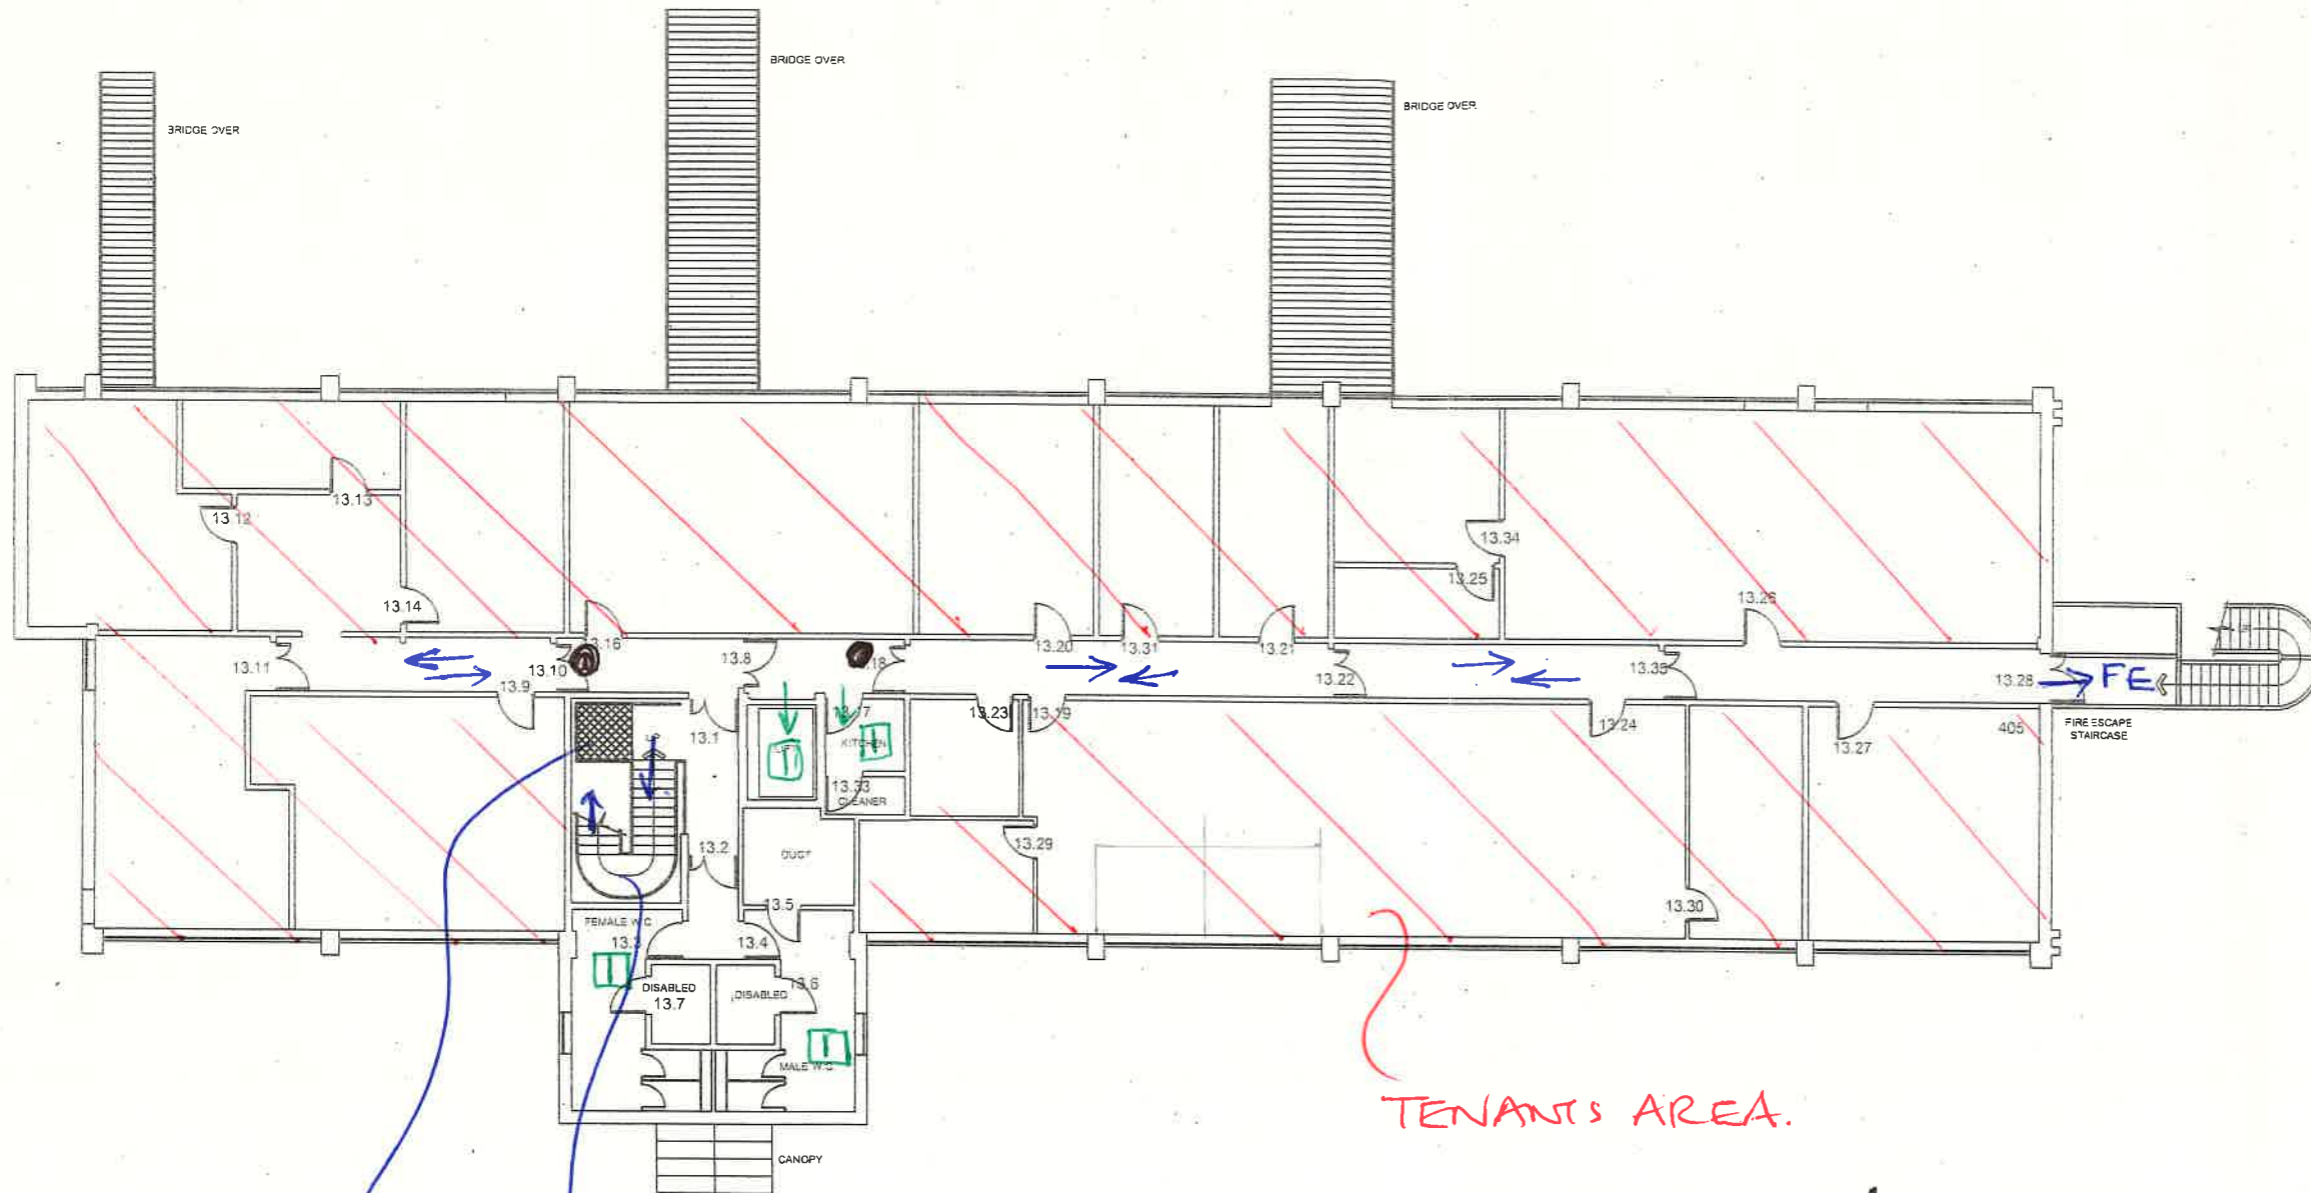

**AS  
CONSTRUCTED**

REV	DATE	AMENDMENTS
G	04/10/2016	Door 13.10 relocated and number 13.13 added.
H	16/01/2018	Door 13.32 removed.
I	02/01/2019	Room 13.15 removed to reflect Chris Holland's annotated plan.

PROJECT OFFICER

PROJECT  
IC1

DESCRIPTION OF SHEET  
FIRST FLOOR XREF

SHEET NUMBER OF

DRAWN BY  
A DEAN

DATE  
NOVEMBER 2013

SCALE  
1:200 @ A3

FILE NUMBER

DRAWING NUMBER  
B049-X-03-1

REVISION I	DRAWING SIZE A3
---------------	--------------------



Keele University

ESTATES & DEVELOPMENT DIRECTORATE  
KEELE  
STAFFORDSHIRE  
ST5 5BG

WAITING SPACE FOR STAIRS.

TWO WAY STAIRS.

TENANT'S AREA.

**1/FLOOR**

● CARD ACCESS


FE FIRE ESCAPE

→ DIRECTION OF TRAVEL

□ OCCUPANCY LEVELS

**NOTES**


THE CONTRACTOR TO CHECK ALL WORKING DIMENSIONS ON SITE BEFORE PUTTING ANY WORK IN HAND.  
 ANY DISCREPANCY SHALL BE BROUGHT TO THE ATTENTION OF THE PROJECT OFFICER WITHOUT DELAY

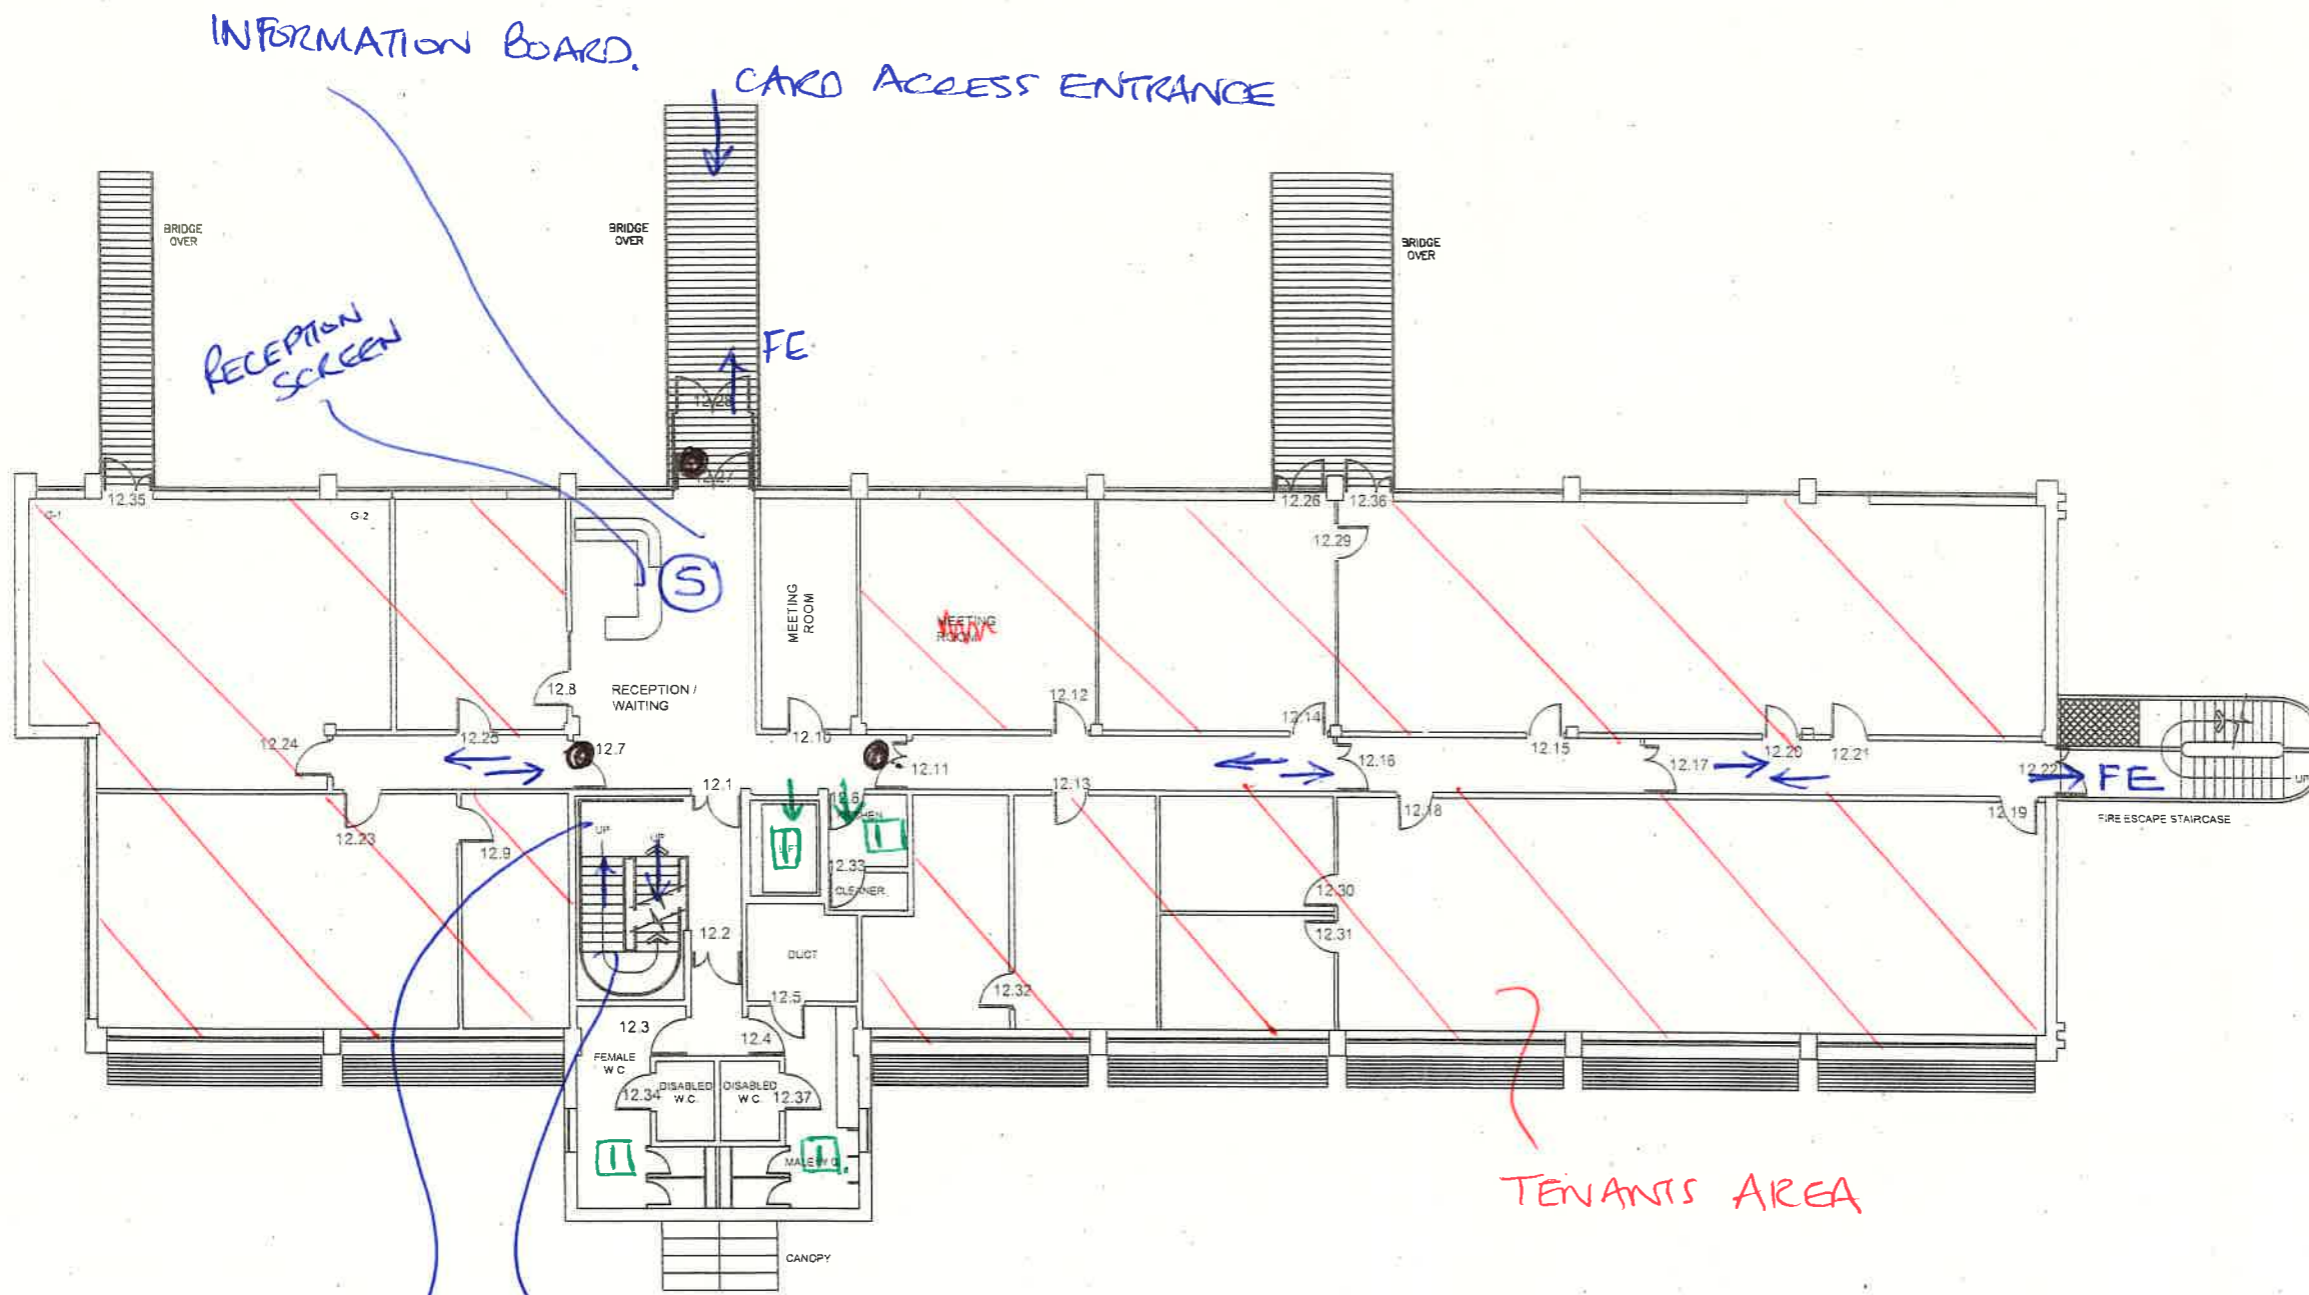

**G/FLOOR**


- CARD ACCESS
- Ⓢ HAND SANITISER
- FE FIRE ESCAPE
- DIRECTION OF TRAVEL
- OCCURANCY LEVELS

AS CONSTRUCTED		
REV	DATE	AMENDMENTS
G	04/10/2016	12.33, 12.34, 12.35, 12.36 and 12.37 added.
H	02/01/2019	Doors 12.26 and 12.29 relocated to reflect Chris Holland's annotated plan.
PROJECT OFFICER		
PROJECT IC1		
DESCRIPTION OF SHEET GROUND FLOOR XREF		
SHEET NUMBER		OF
DRAWN BY A DEAN		
DATE NOVEMBER 2013		
SCALE 1:200 @ A3		
FILE NUMBER		
DRAWING NUMBER B049-X-02-1		DRAWING SIZE A3
REVISION H		DRAWING SIZE A3

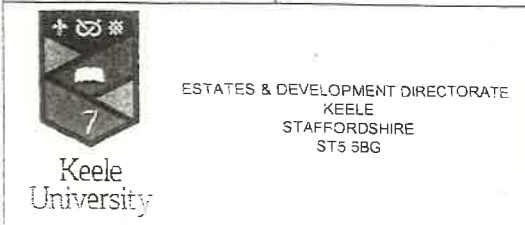

**NOTES**

THE CONTRACTOR TO CHECK ALL WORKING DIMENSIONS ON SITE BEFORE PUTTING ANY WORK IN HAND.  
ANY DISCREPANCY SHALL BE BROUGHT TO THE ATTENTION OF THE PROJECT OFFICER WITHOUT DELAY

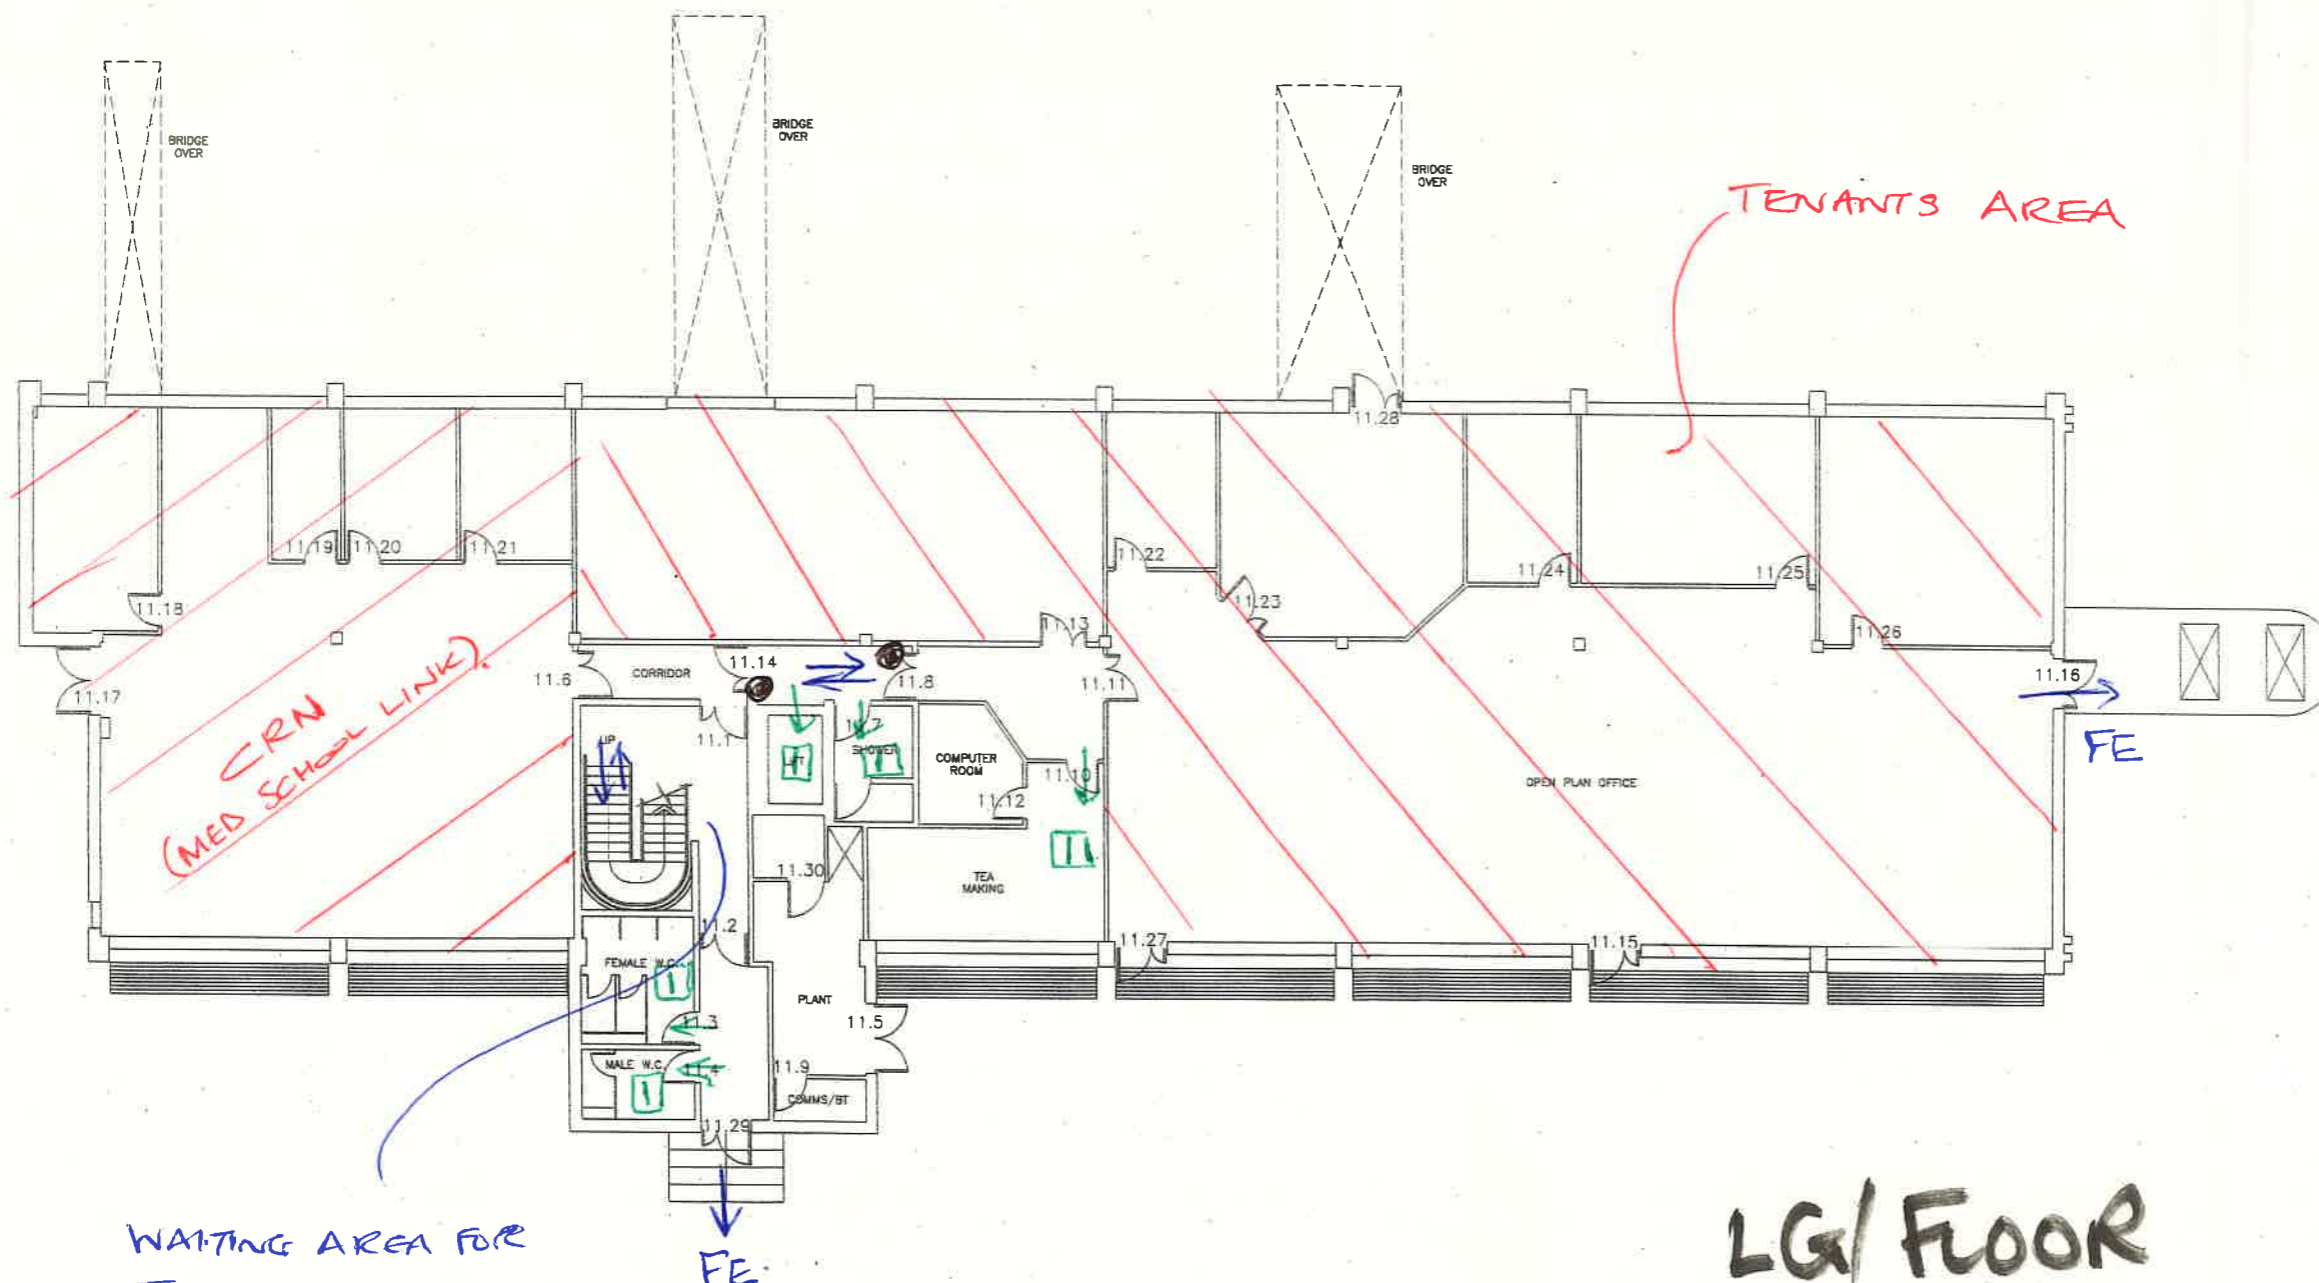

CRN  
(MED SCHOOL LINK)

TENANTS AREA

WAITING AREA FOR  
TOILETS + STAIRS.

**LG/ FLOOR**

- ⊙ CARD ACCESS.
- FE FIRE ESCAPE
- ↔ DIRECTION OF TRAVEL
- OCCUPANCY LEVELS

AS CONSTRUCTED		
REV	DATE	AMENDMENTS
F	04/10/2016	11.29 added and alteration to 11.9.
PROJECT OFFICER		
PROJECT IC1		
DESCRIPTION OF SHEET LOWER GROUND FLOOR XREF		
SHEET NUMBER                      OF		
DRAWN BY A DEAN		
DATE NOVEMBER 2013		
SCALE 1:200 @ A3		
FILE NUMBER		
DRAWING NUMBER B049-X-01-1		
REVISION F	DRAWING SIZE A3	